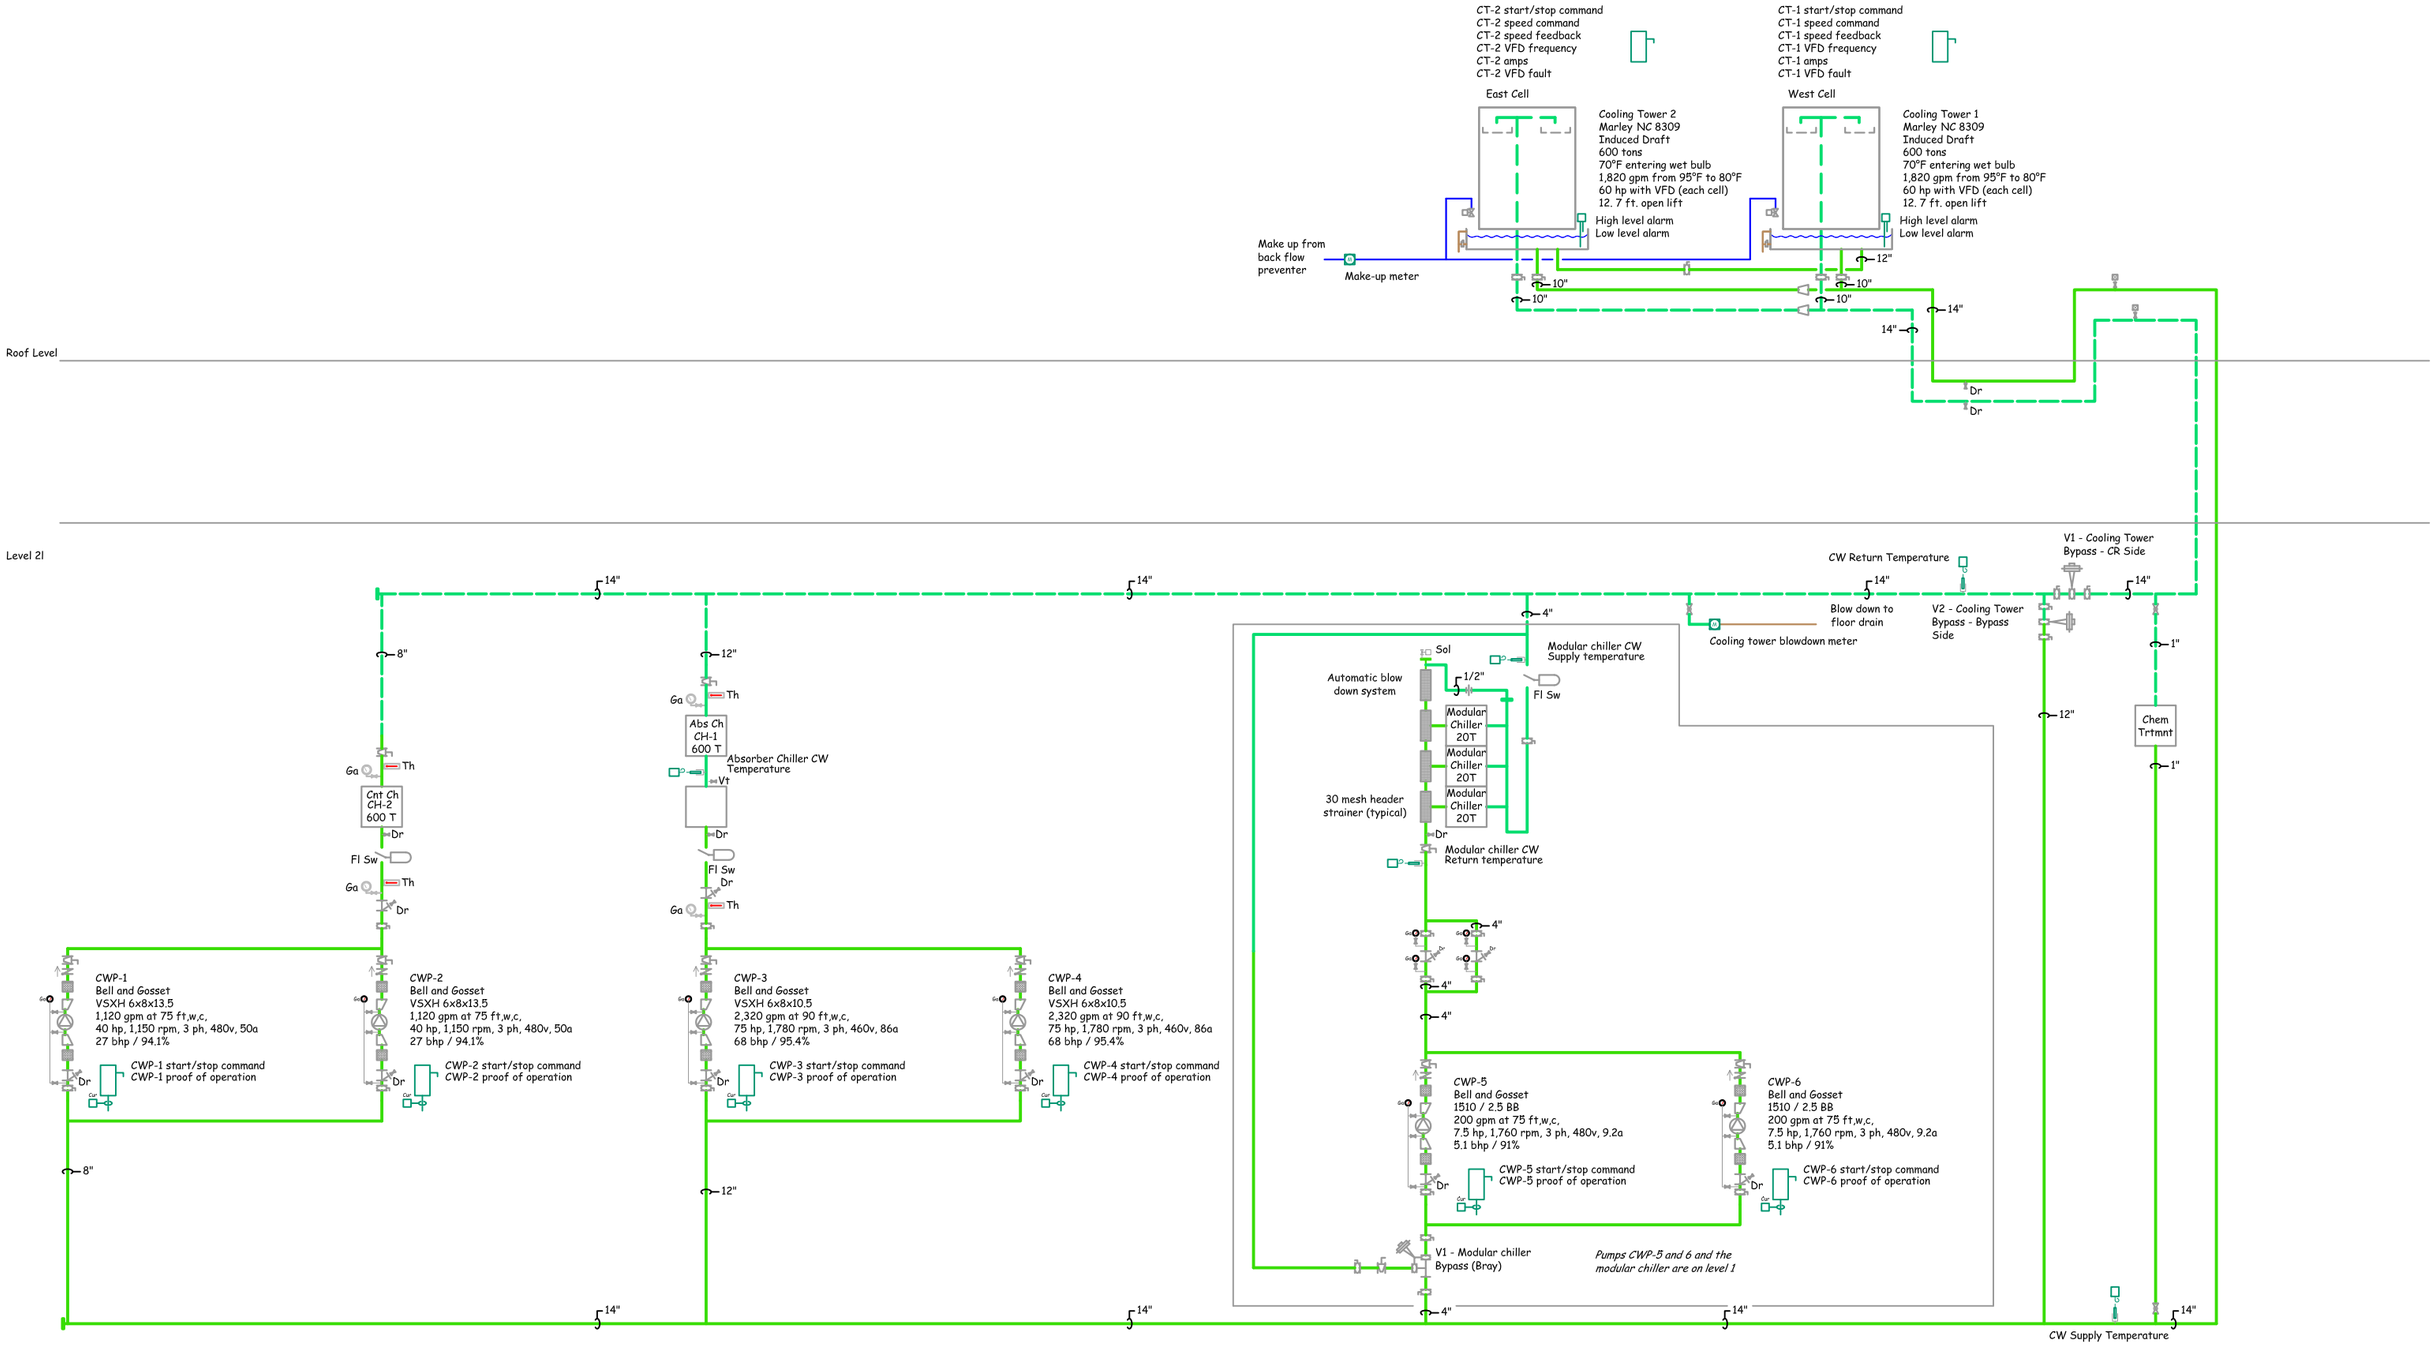

Facility Dynamics Engineering
Home Office: 6760 Alexander Bell Drive, Suite 220, Columbia, MD 21046 Phone: 410-290-0900 Web: www.FacilityDynamics.com
Southern Califonial Satellite Office: 23315 Modoc Ct., Gavilane Hills, CA, 92570; Phone: 951-940-1043
NW Satellite Office: 8560 North Buchanan Avenue, Portland, OR 97203 Phone: 503-286-1494

UC Berkeley C.I.T.R.I.S Condenser Water System Overview

Revisions: 1. 02-02-10 - Added auto air vents, modular chiller strainers
2. 02-16-10 - As-Built Modifications (RS)

Drawn by: DAS	Date: 12-08-08
Checked by:	

CW-1 of 1